


REVISED

EXISTING WATER SUPPLY
STUB-OUT AND DRAINAGE TIE
IN - LICENSED PLUMBER TO
ATTACH HOOK UP PER CODE
FIELD VERIFY LOCATION

PLUMBING FOR SINK
AND ICE MAKER UNDER
SEPARATE PERMIT

FOR POOL LOCATION ONLY

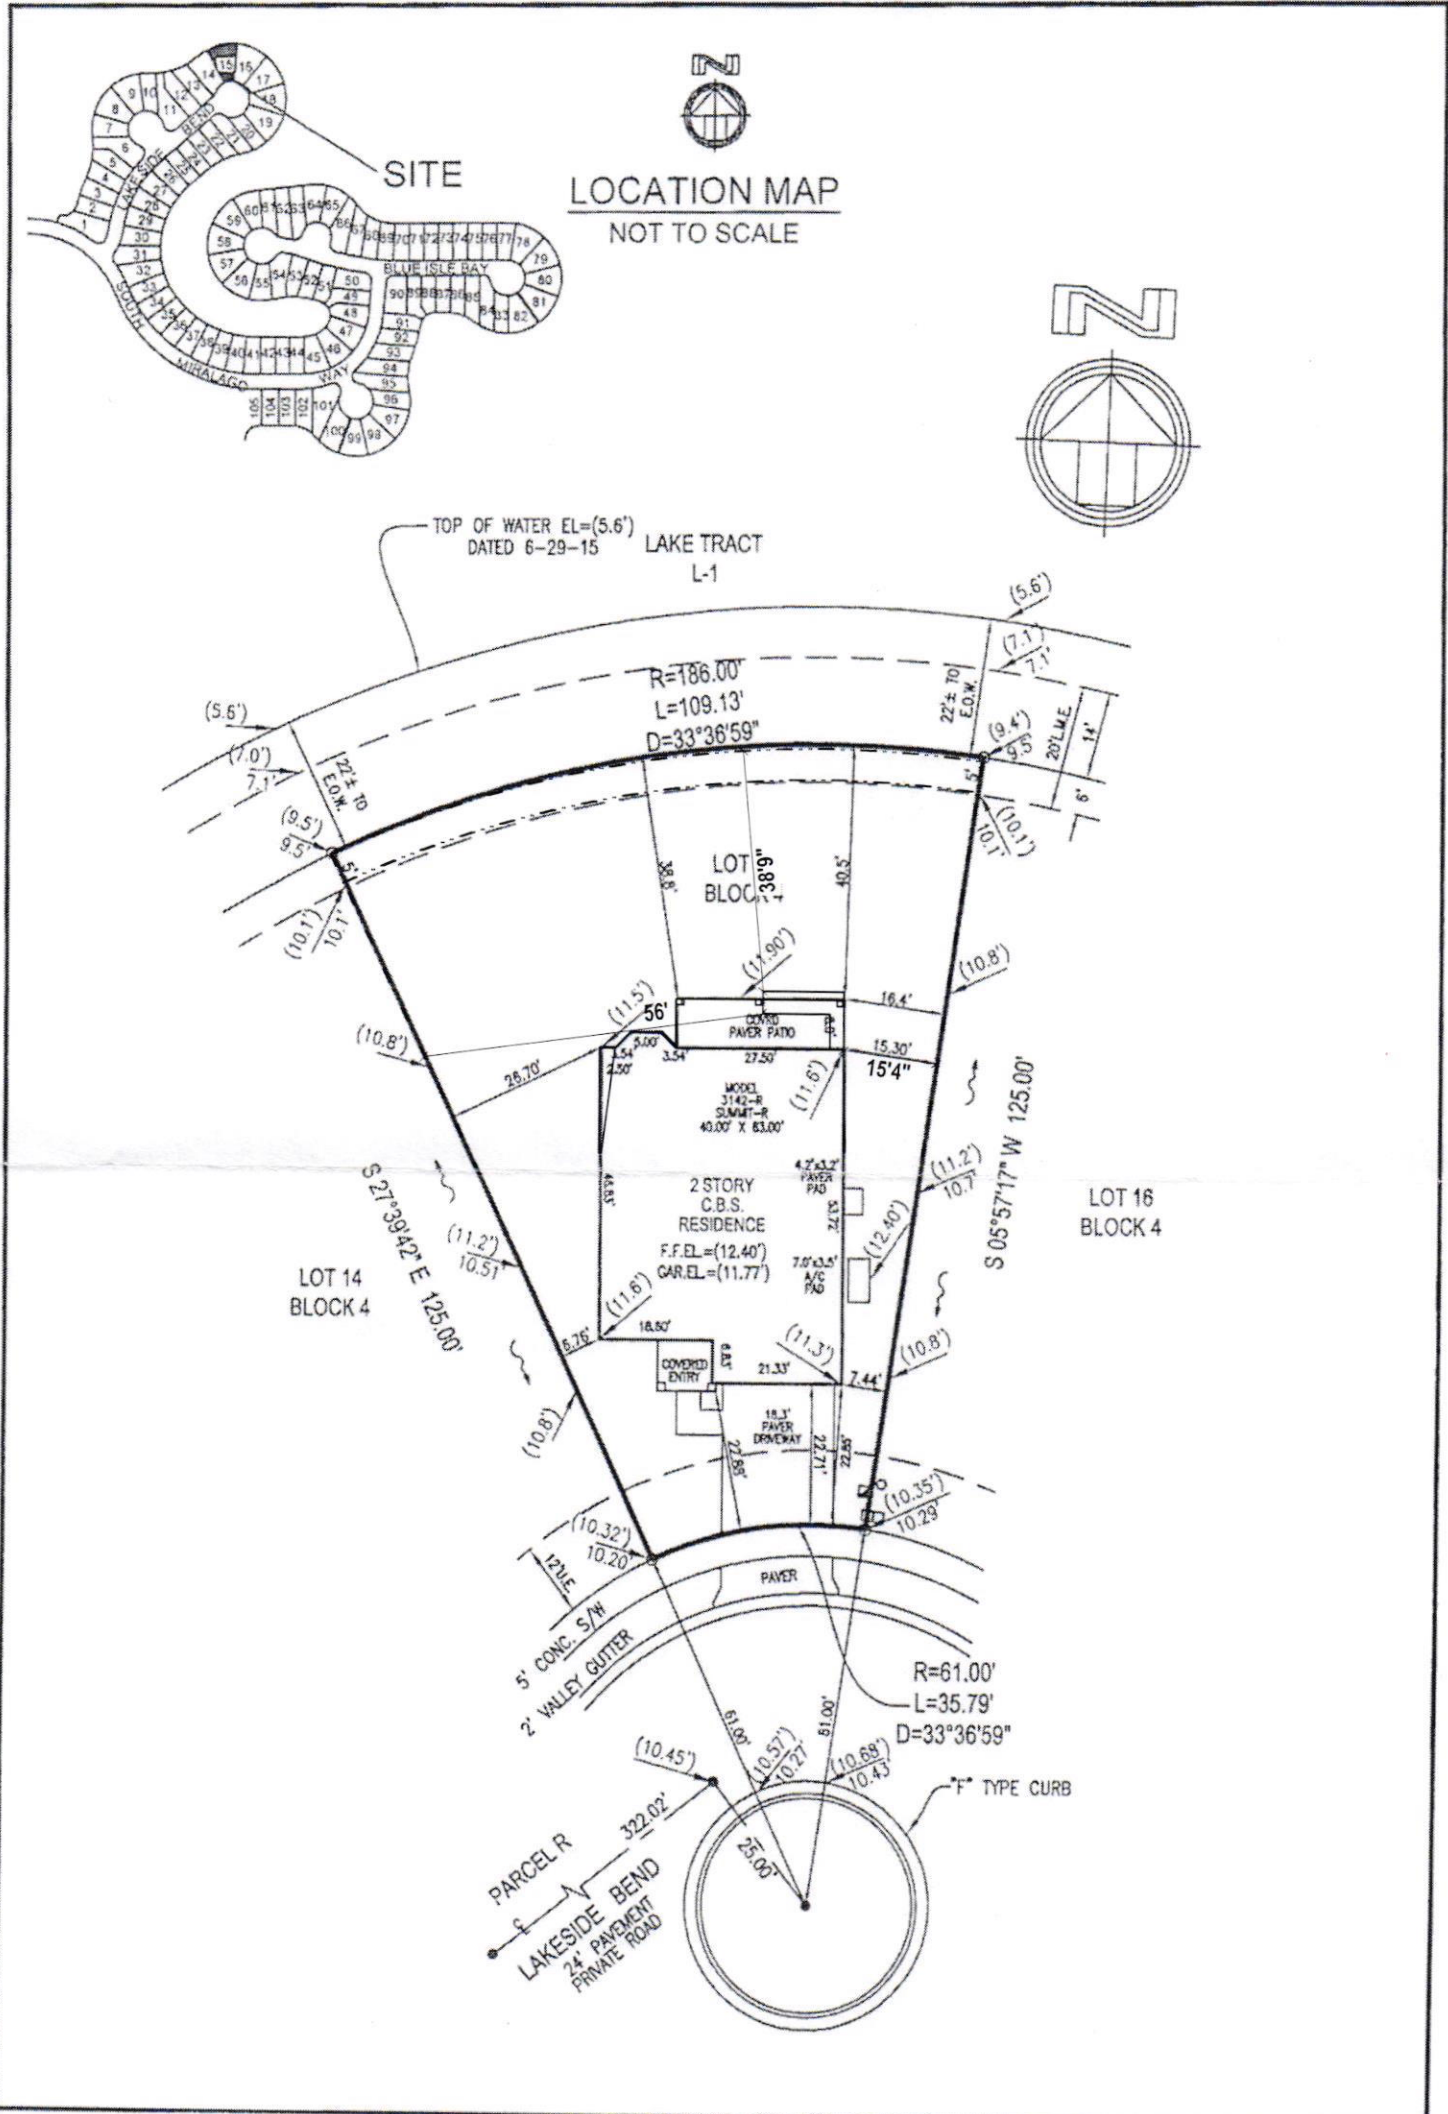

REVISIONS	F.B./PG.	DATE	BY	CK'D
FINAL SURVEY		6-29-15	KW	SMP
SLAB SPOT		3-2-15	SMP	
FORMBOARD SPOT		2-17-15	SMP	
PLOT PLAN MODEL 3142-AR		5-15-14	TW	SMP

LEGEND:	
	CATCH BASIN
	CABLE JUNCTION BOX
	CENTERLINE
	CLEANOUT
	CONCRETE MONUMENT
	ELECTRIC SERVICE
	ELEVATION, AS-BUILT
	ELEVATION, PROPOSED
	FIRE HYDRANT
	FLOW ARROW
	IR&C LB2936, SET 1/2"
	LIGHT POLE - CONC.
	LIGHT POLE - METAL
	MANHOLE - SANITARY SEWER
	MANHOLE - STORM SEWER
	NAIL & TIN TAB
	NAIL & DISC
	SANITARY SERVICE(S)
	TELEPHONE JUNCTION BOX
	WATER METER
	WATER VALVE
	YARD DRAIN

DeBUYS PLAT- MIRA LAGO

JOB NO.: 120508

SCALE: 1" = 30'

SHEET 2 OF 2 SHEETS