

LOCATION MAP
NOT TO SCALE

THIS SURVEY


LOT 74
BLOCK 8

BUFFER TRACT B-1

N01°16'33"W
50.00'

LOT 75
BLOCK 8

LOT 76
BLOCK 8

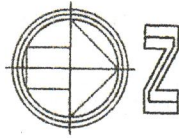


Drawing is schematic and may change due to field conditions
Irrigation to be installed according to appendix F of the Florida Building Code

Major components to be manufactured by Hunter, Rainbird, or Equal

All sleeves to 2 times pipe diameter minimum

LEGEND

- ⊙ ⊙ ⊙ Pop-Up Spray Heads
- ▲ ▲ Pop-Up Rotor Heads
- ⊕ Point of Connection to Common Irrigation mainline
- ⊕ Point of Connection location may vary along LME

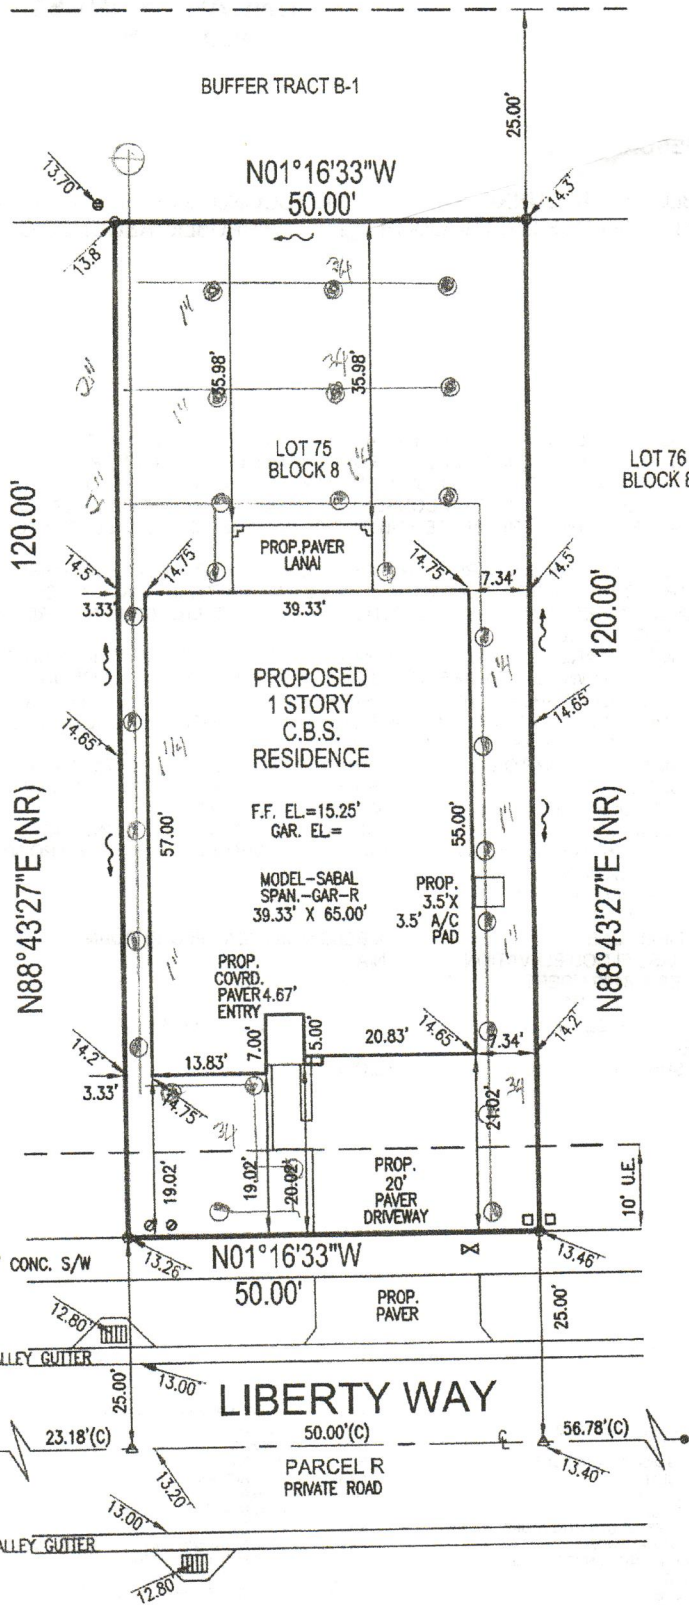

PLOT PLAN MODEL SABAL SPAN.-GAR-R	01-04-2023	DL	SMP
REVISIONS	F.B./PG.	DATE	BY CK'D
McJUNKIN FARMS PLAT- PARKLAND FALLS		JOB NO.: 8347-H	SCALE: 1" = 20'
			SHEET 2 OF 2 SHEETS

<p>LEGEND:</p> <ul style="list-style-type: none"> ▭ CATCH BASIN ⊞ CABLE JUNCTION BOX ⊕ CENTERLINE ⊙ CLEANOUT ⊙ CONCRETE MONUMENT ⊕ ELECTRIC SERVICE (7.7) ELEVATION, AS-BUILT 1.7 ELEVATION, PROPOSED ⊕ FIRE HYDRANT ⊕ FLOW ARROW 	<ul style="list-style-type: none"> ⊙ IR&C LB2936, SET 1/2" ⊕ LIGHT POLE - CONC. ⊕ LIGHT POLE - METAL ⊙ MANHOLE - SANITARY SEWER ⊙ MANHOLE - STORM SEWER ▲ NAIL & TIN TAB ▲ NAIL & DISC ⊕ SANITARY SERVICE(S) ⊕ TELEPHONE JUNCTION BOX ⊕ WATER METER ⊕ WATER VALVE ⊕ YARD DRAIN
---	--

26 Heads