


THIS SURVEY

LAKE TRACT L-3
D.W.E.=8.5' N.A.V.D.
WATER EL.=(8.5')
10-19-2023

LOCATION MAP
NOT TO SCALE

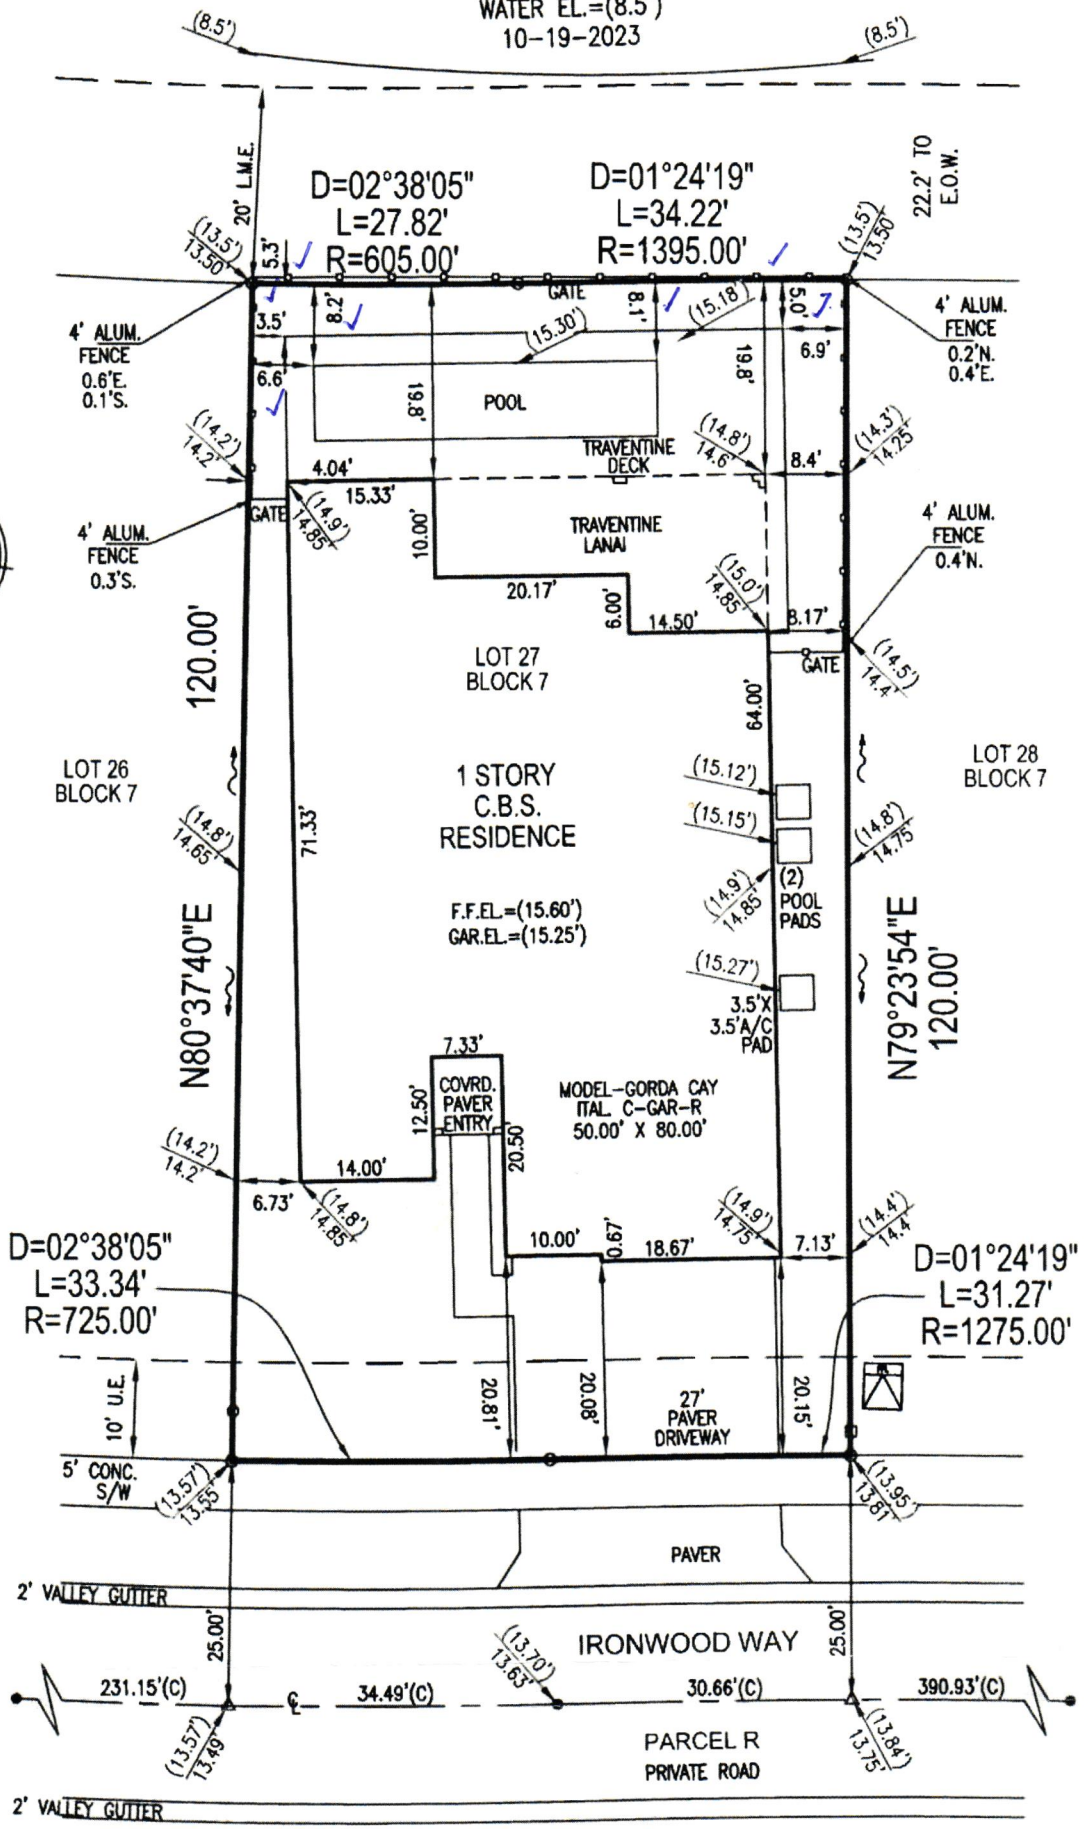

REVISIONS	F.B./PG.	DATE	BY	CK'D
UPDATE SURVEY		10-19-2023	DL	SMP
FINAL SURVEY		11-18-2022	DL	SMP
SLAB SPOT		05-17-2022	SMP	
FORMBOARD SPOT		04-13-2022	SMP	
PLOT PLAN MODEL GORDA CAY ITAL C-GAR-R		12-22-2021	DL	SMP

LEGEND:	
	CATCH BASIN
	CABLE JUNCTION BOX
	CENTERLINE
	CLEANOUT
	CONCRETE MONUMENT
	ELECTRIC SERVICE
	ELEVATION, AS-BUILT
	ELEVATION, PROPOSED
	FIRE HYDRANT
	FLOW ARROW
	IR&C LB2936, SET 1/2"
	LIGHT POLE - CONC.
	LIGHT POLE - METAL
	MANHOLE - SANITARY SEWER
	MANHOLE - STORM SEWER
	NAIL & TIN TAB
	NAIL & DISC
	SANITARY SERVICE(S)
	TELEPHONE JUNCTION BOX
	WATER METER
	WATER VALVE
	YARD DRAIN